


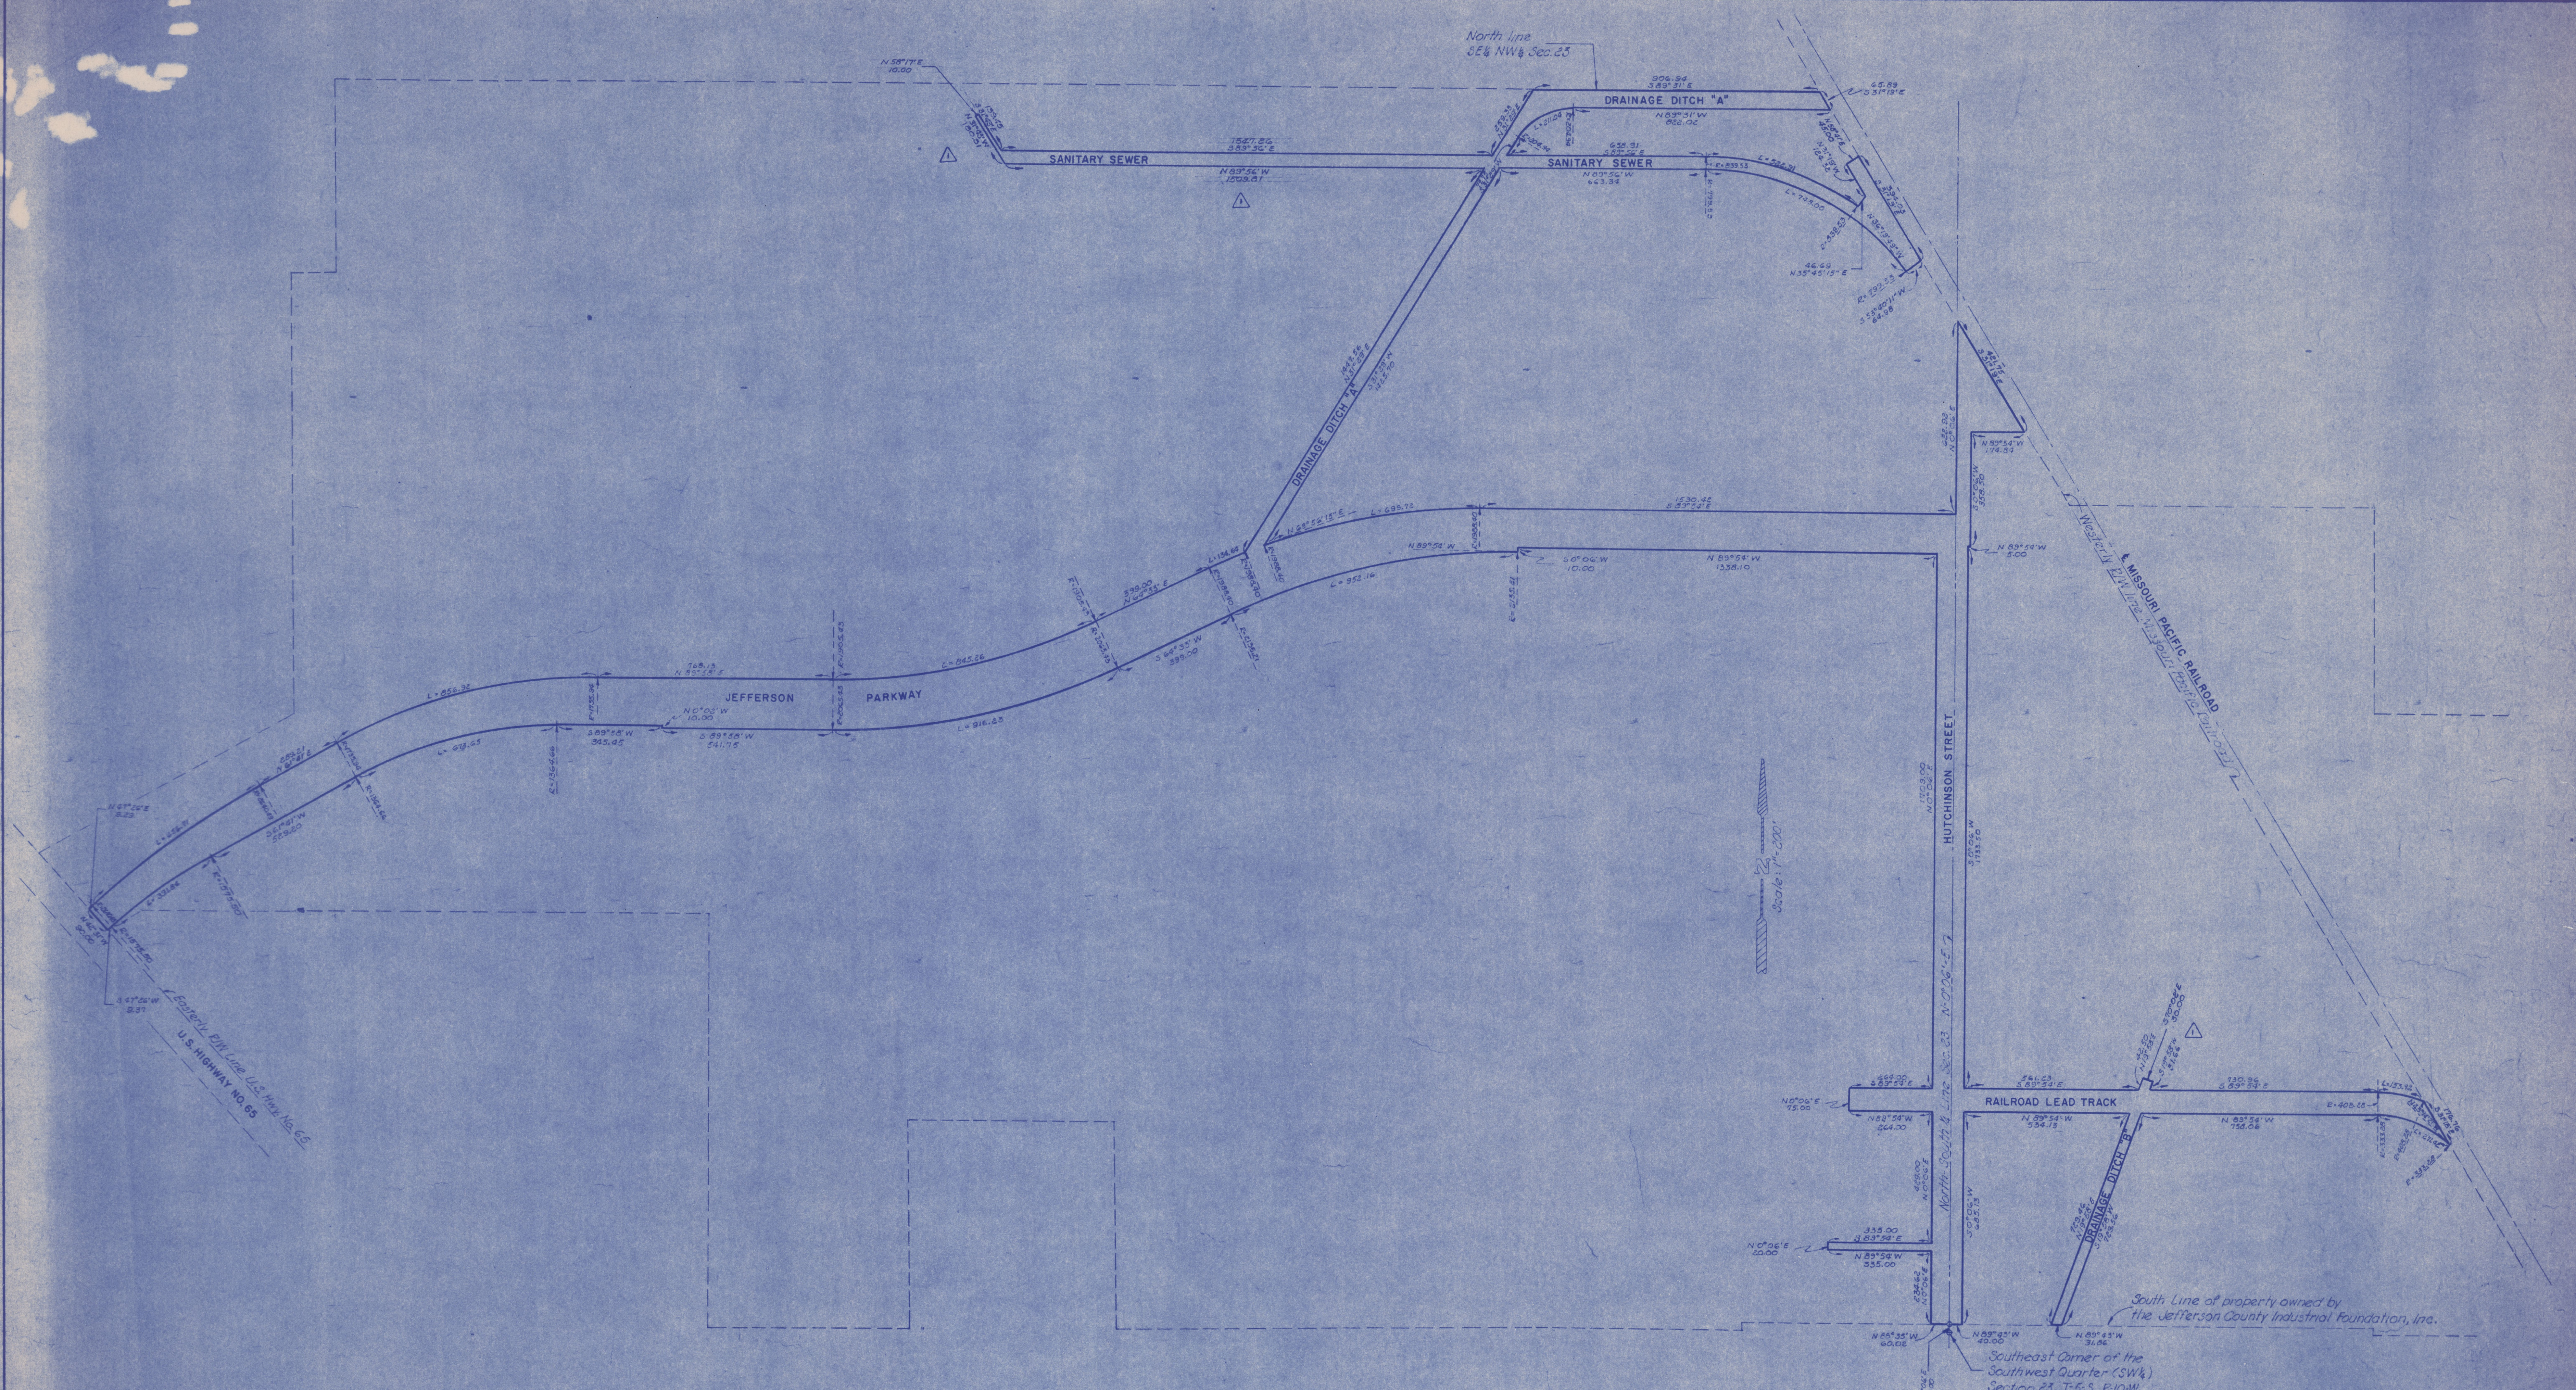

PLAT OF SURVEY

SHOWING CONSTRUCTION AREAS FOR INSTALLATION OF PERMANENT FACILITIES INCLUDED IN CONTRACTS A, B, and C - EDA PROJECT NO. 08-1-00672

JEFFERSON INDUSTRIAL PARK
Jefferson County, Pine Bluff, Arkansas.

GEORGE E. BUTLER & ASSOCIATES, INC.
Consulting Engineers
ONE FOURTEEN WEST TENTH STREET - KANSAS CITY, MISSOURI
TELEPHONE 516-2512808



Revised to conform to
As-Built conditions. 3-18-70

1" = 200'